



<div><div>Key</div><div><div><div></div></div>Previously published boundary</div><div><div><div></div></div>Potential land required to construct and operate the Lower Thames Crossing</div></div> <div><div>001S210/10/2017Issued for informationJS/KMTG/TWSC</div><div><div>RevStatusRev DatePurpose of revisionDrawnChk'dAppr'd</div></div></div>										<div>Client<div><div></div>highways england</div></div> <div>Lower Thames Crossing</div>		<div>Project<div>LOWER THAMES CROSSING DEVELOPMENT PHASE</div></div> <div>Drawing title<div>Development Boundary Comparison Key Plan</div></div>		<div>Status<div>S2</div></div> <div><div>Original Size<div>A3</div></div><div>Revision<div>001</div></div><div>Scale<div>1:100,000</div></div></div>	
										<div>Drawn<div>JS/KM</div></div>		<div>Date -<div>10/10/2017</div></div>			
										<div>Checked<div>TG/TW</div></div>		<div>Date -<div>16/10/2017</div></div>			
										<div>Approved<div>SC</div></div>		<div>Date -<div>16/10/2017</div></div>			
										<div>Drawing number<div>HE540039-CJV-GEN-GEN-MAP-DCO-00009</div></div>					



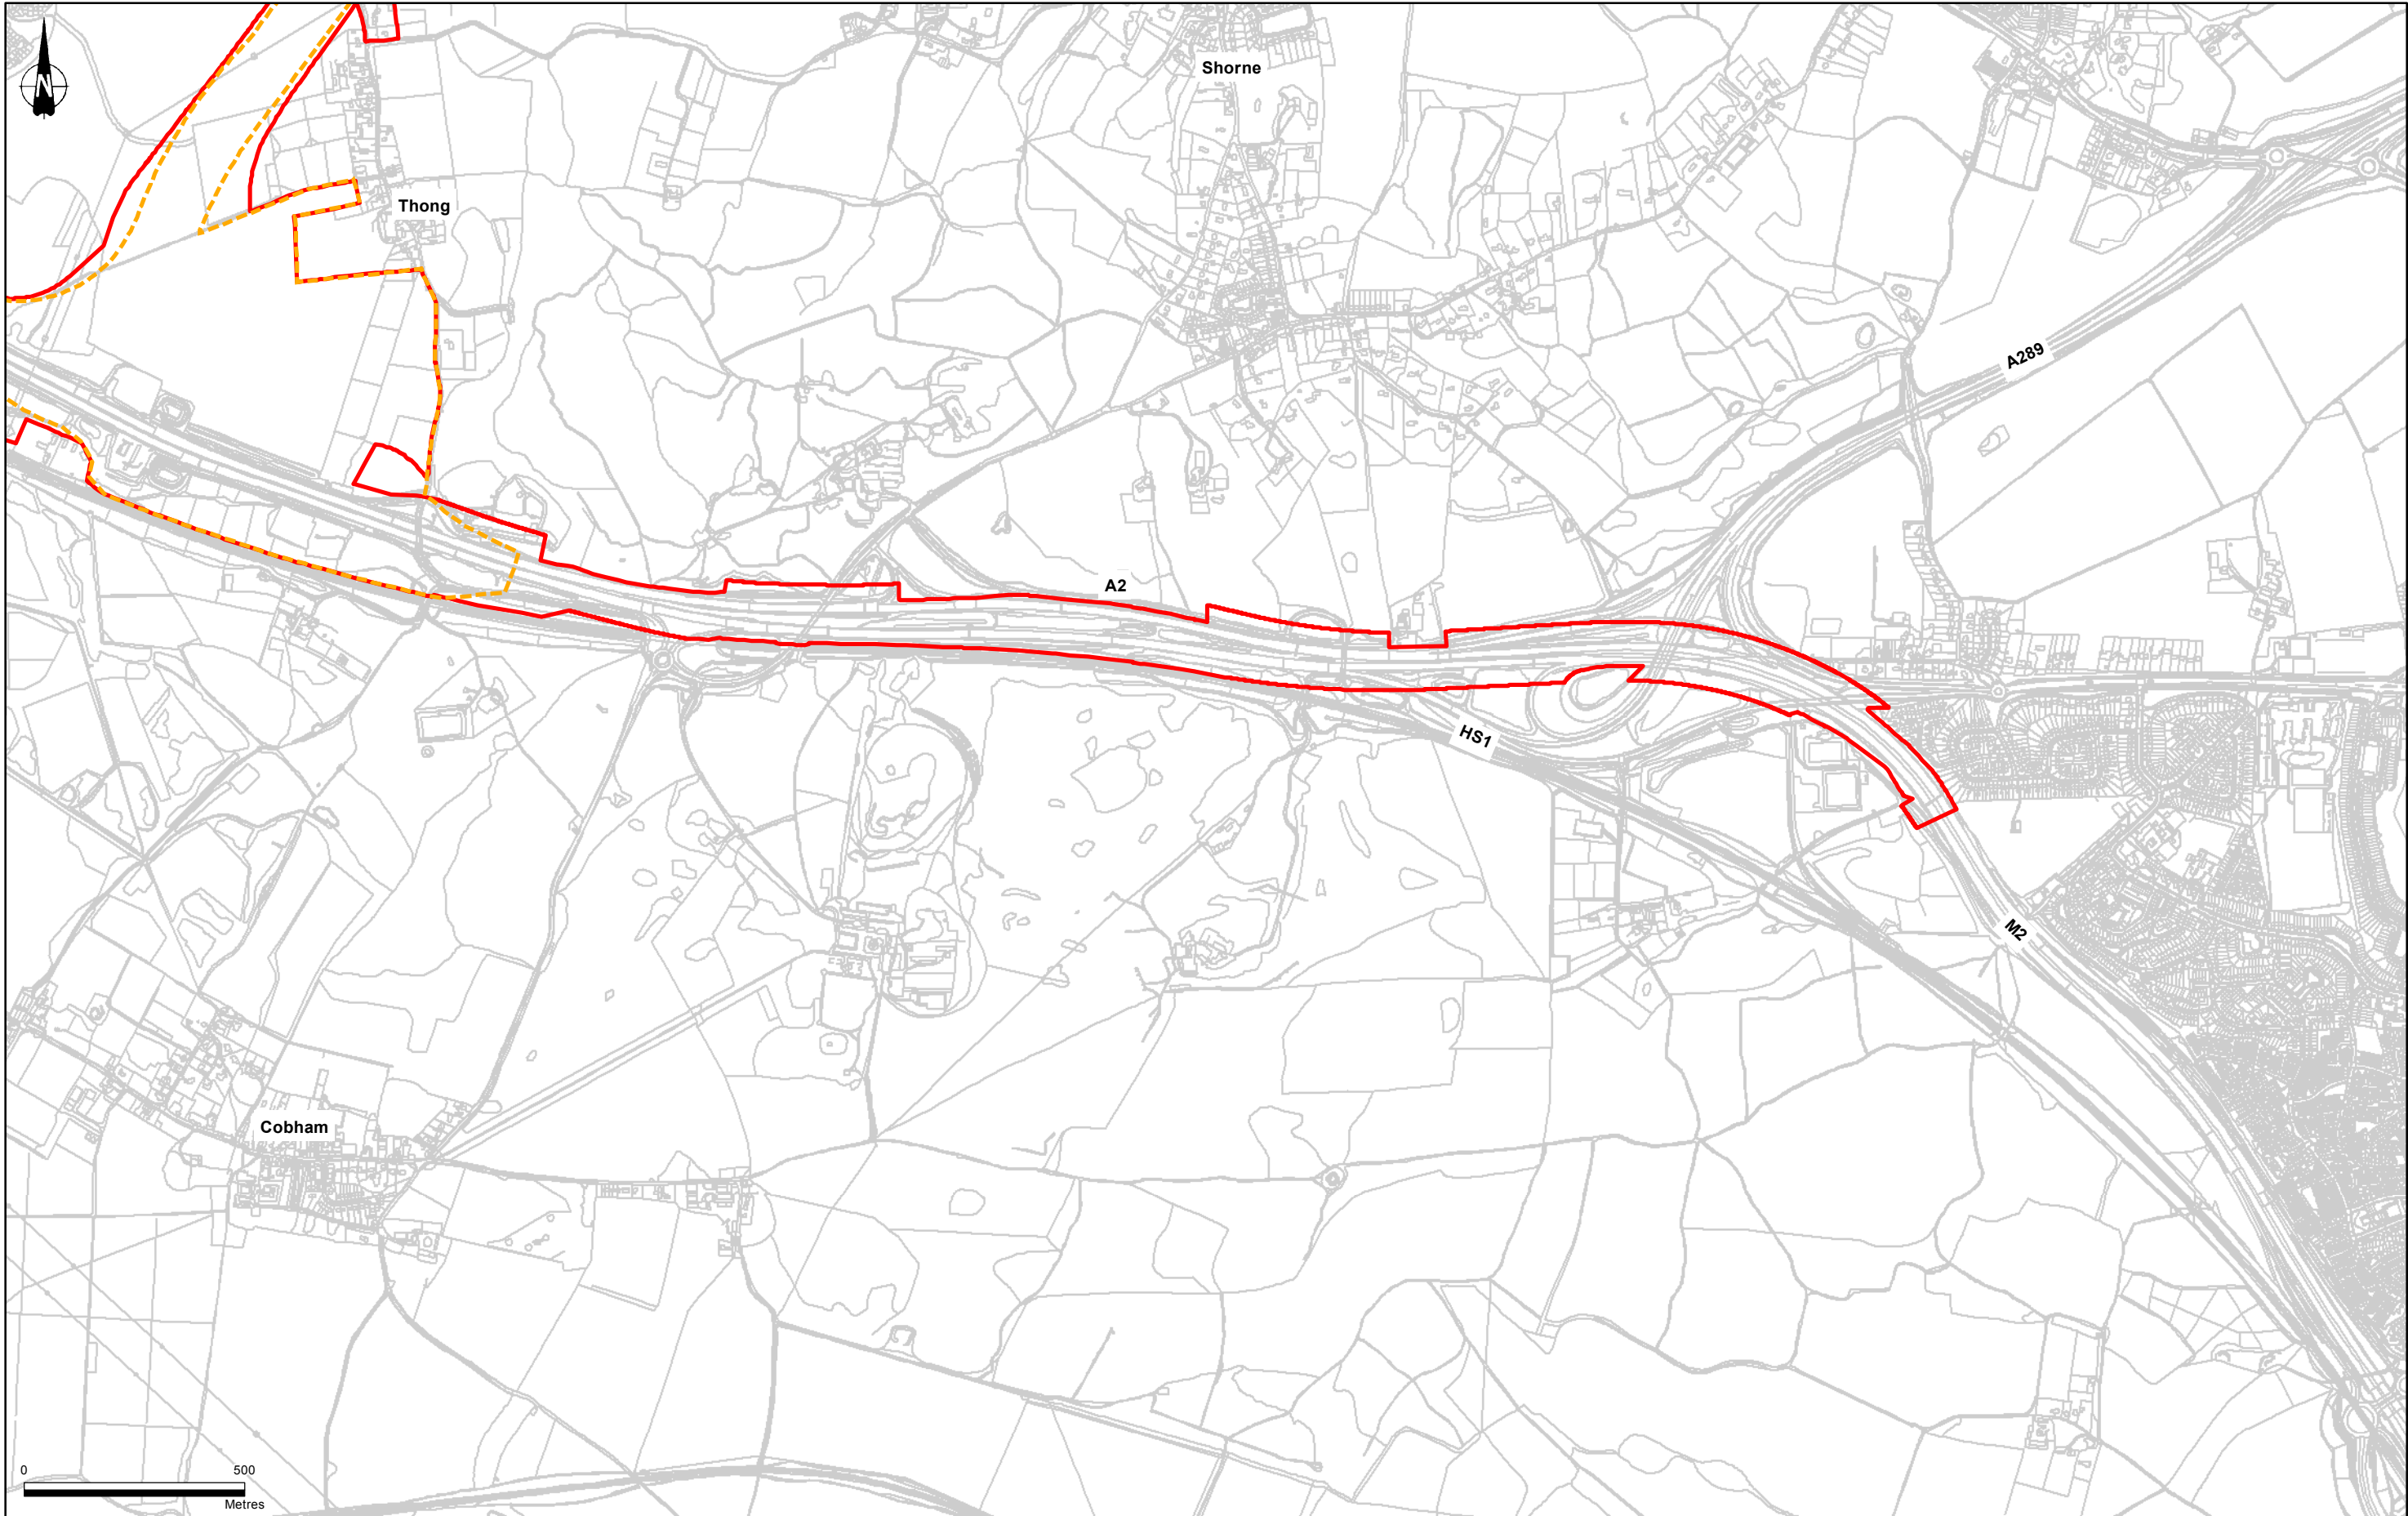


<div>001S210/10/2017Issued for informationJS/KMTG/TWSC</div> <div><table><tr><td>Rev</td><td>Status</td><td>Rev. Date</td><td>Purpose of revision</td><td>Drawn</td><td>Chk'd</td><td>Appr'd</td></tr></table></div>							Rev	Status	Rev. Date	Purpose of revision	Drawn	Chk'd	Appr'd	<div><div>Key:</div><div><div><div></div></div>Previously published boundary</div><div><div><div></div></div>Potential land required to construct and operate the Lower Thames Crossing</div></div>							<div>Client<div><div><div></div></div>highways england</div><div>Lower Thames Crossing</div></div>		<div>Project<div>LOWER THAMES CROSSING DEVELOPMENT PHASE</div><div>Drawing title<div>Development Boundary Comparison Sheet 1 of 7</div></div></div>		<div>Status<div>S2</div><div>DrawnJS/KMCheckedTG/TWApprovedSC</div><div>Drawing number<div>HE540039-CJV-GEN-GEN-MAP-DCO-00010</div></div></div>		<div>Original Size<div>A3</div>Revision<div>001</div>Scale<div>1:14,000</div><div>Date - 10/10/2017</div><div>Date - 16/10/2017</div><div>Date - 16/10/2017</div></div>	
Rev	Status	Rev. Date	Purpose of revision	Drawn	Chk'd	Appr'd																						

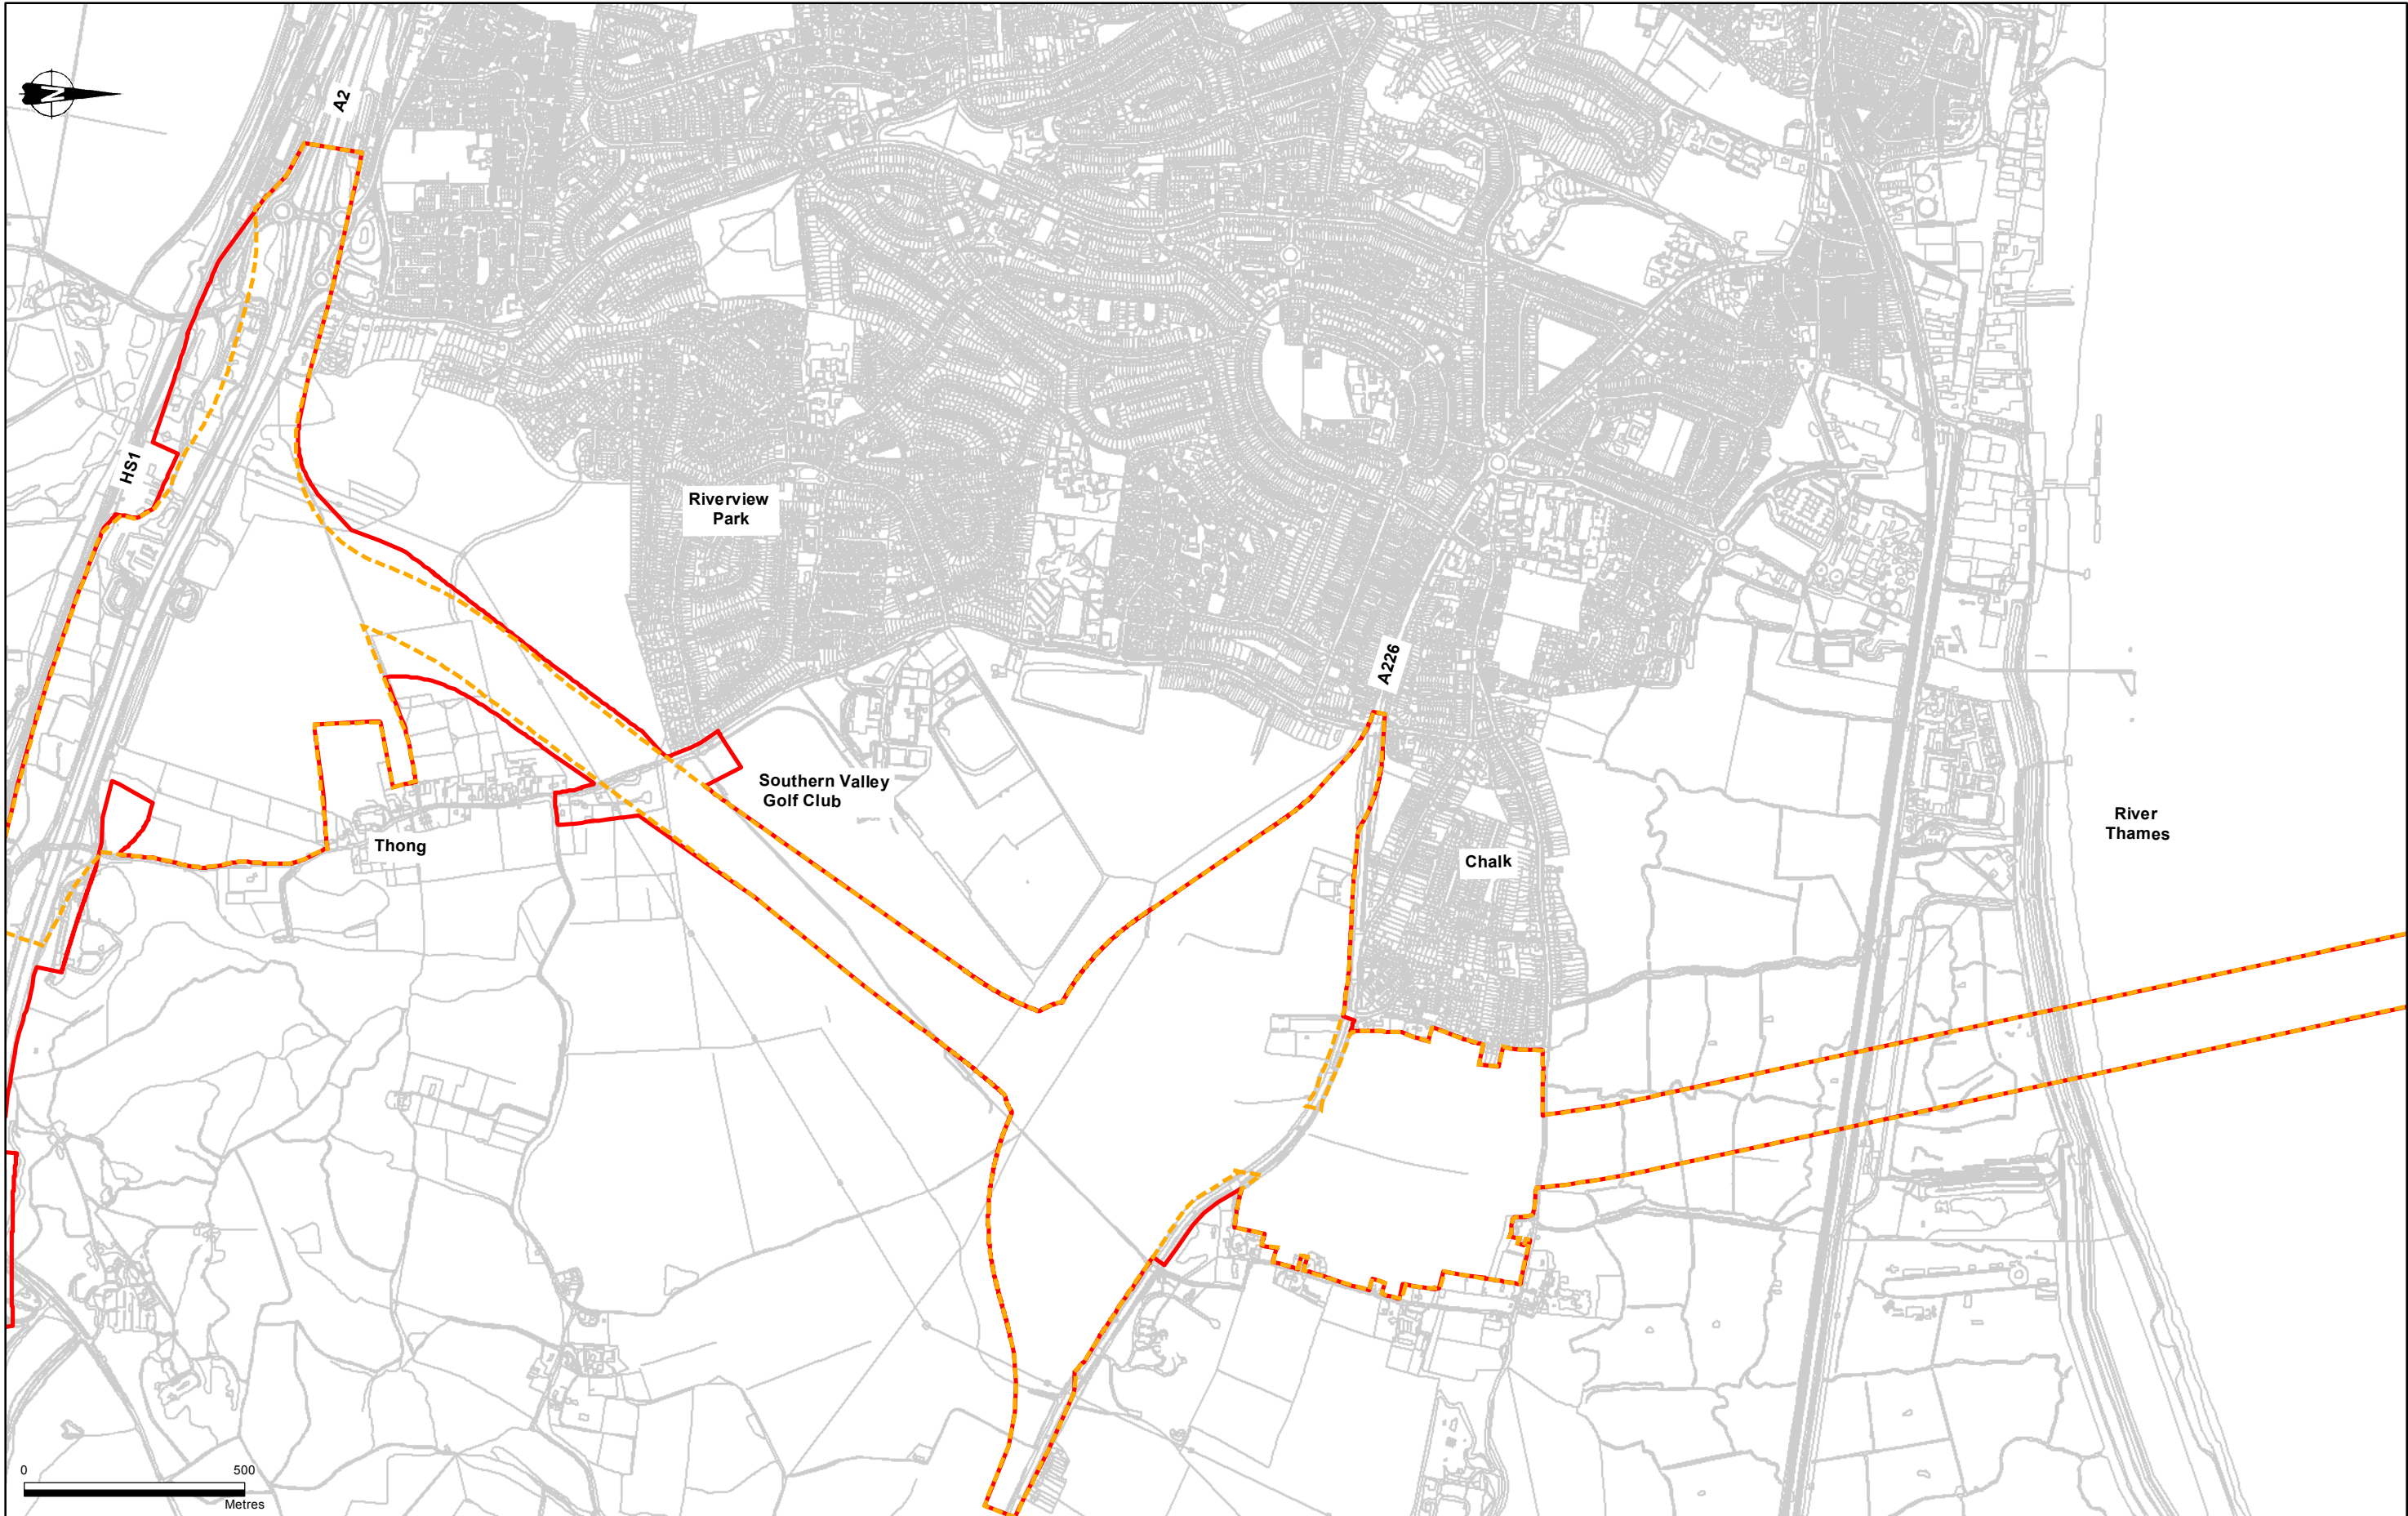


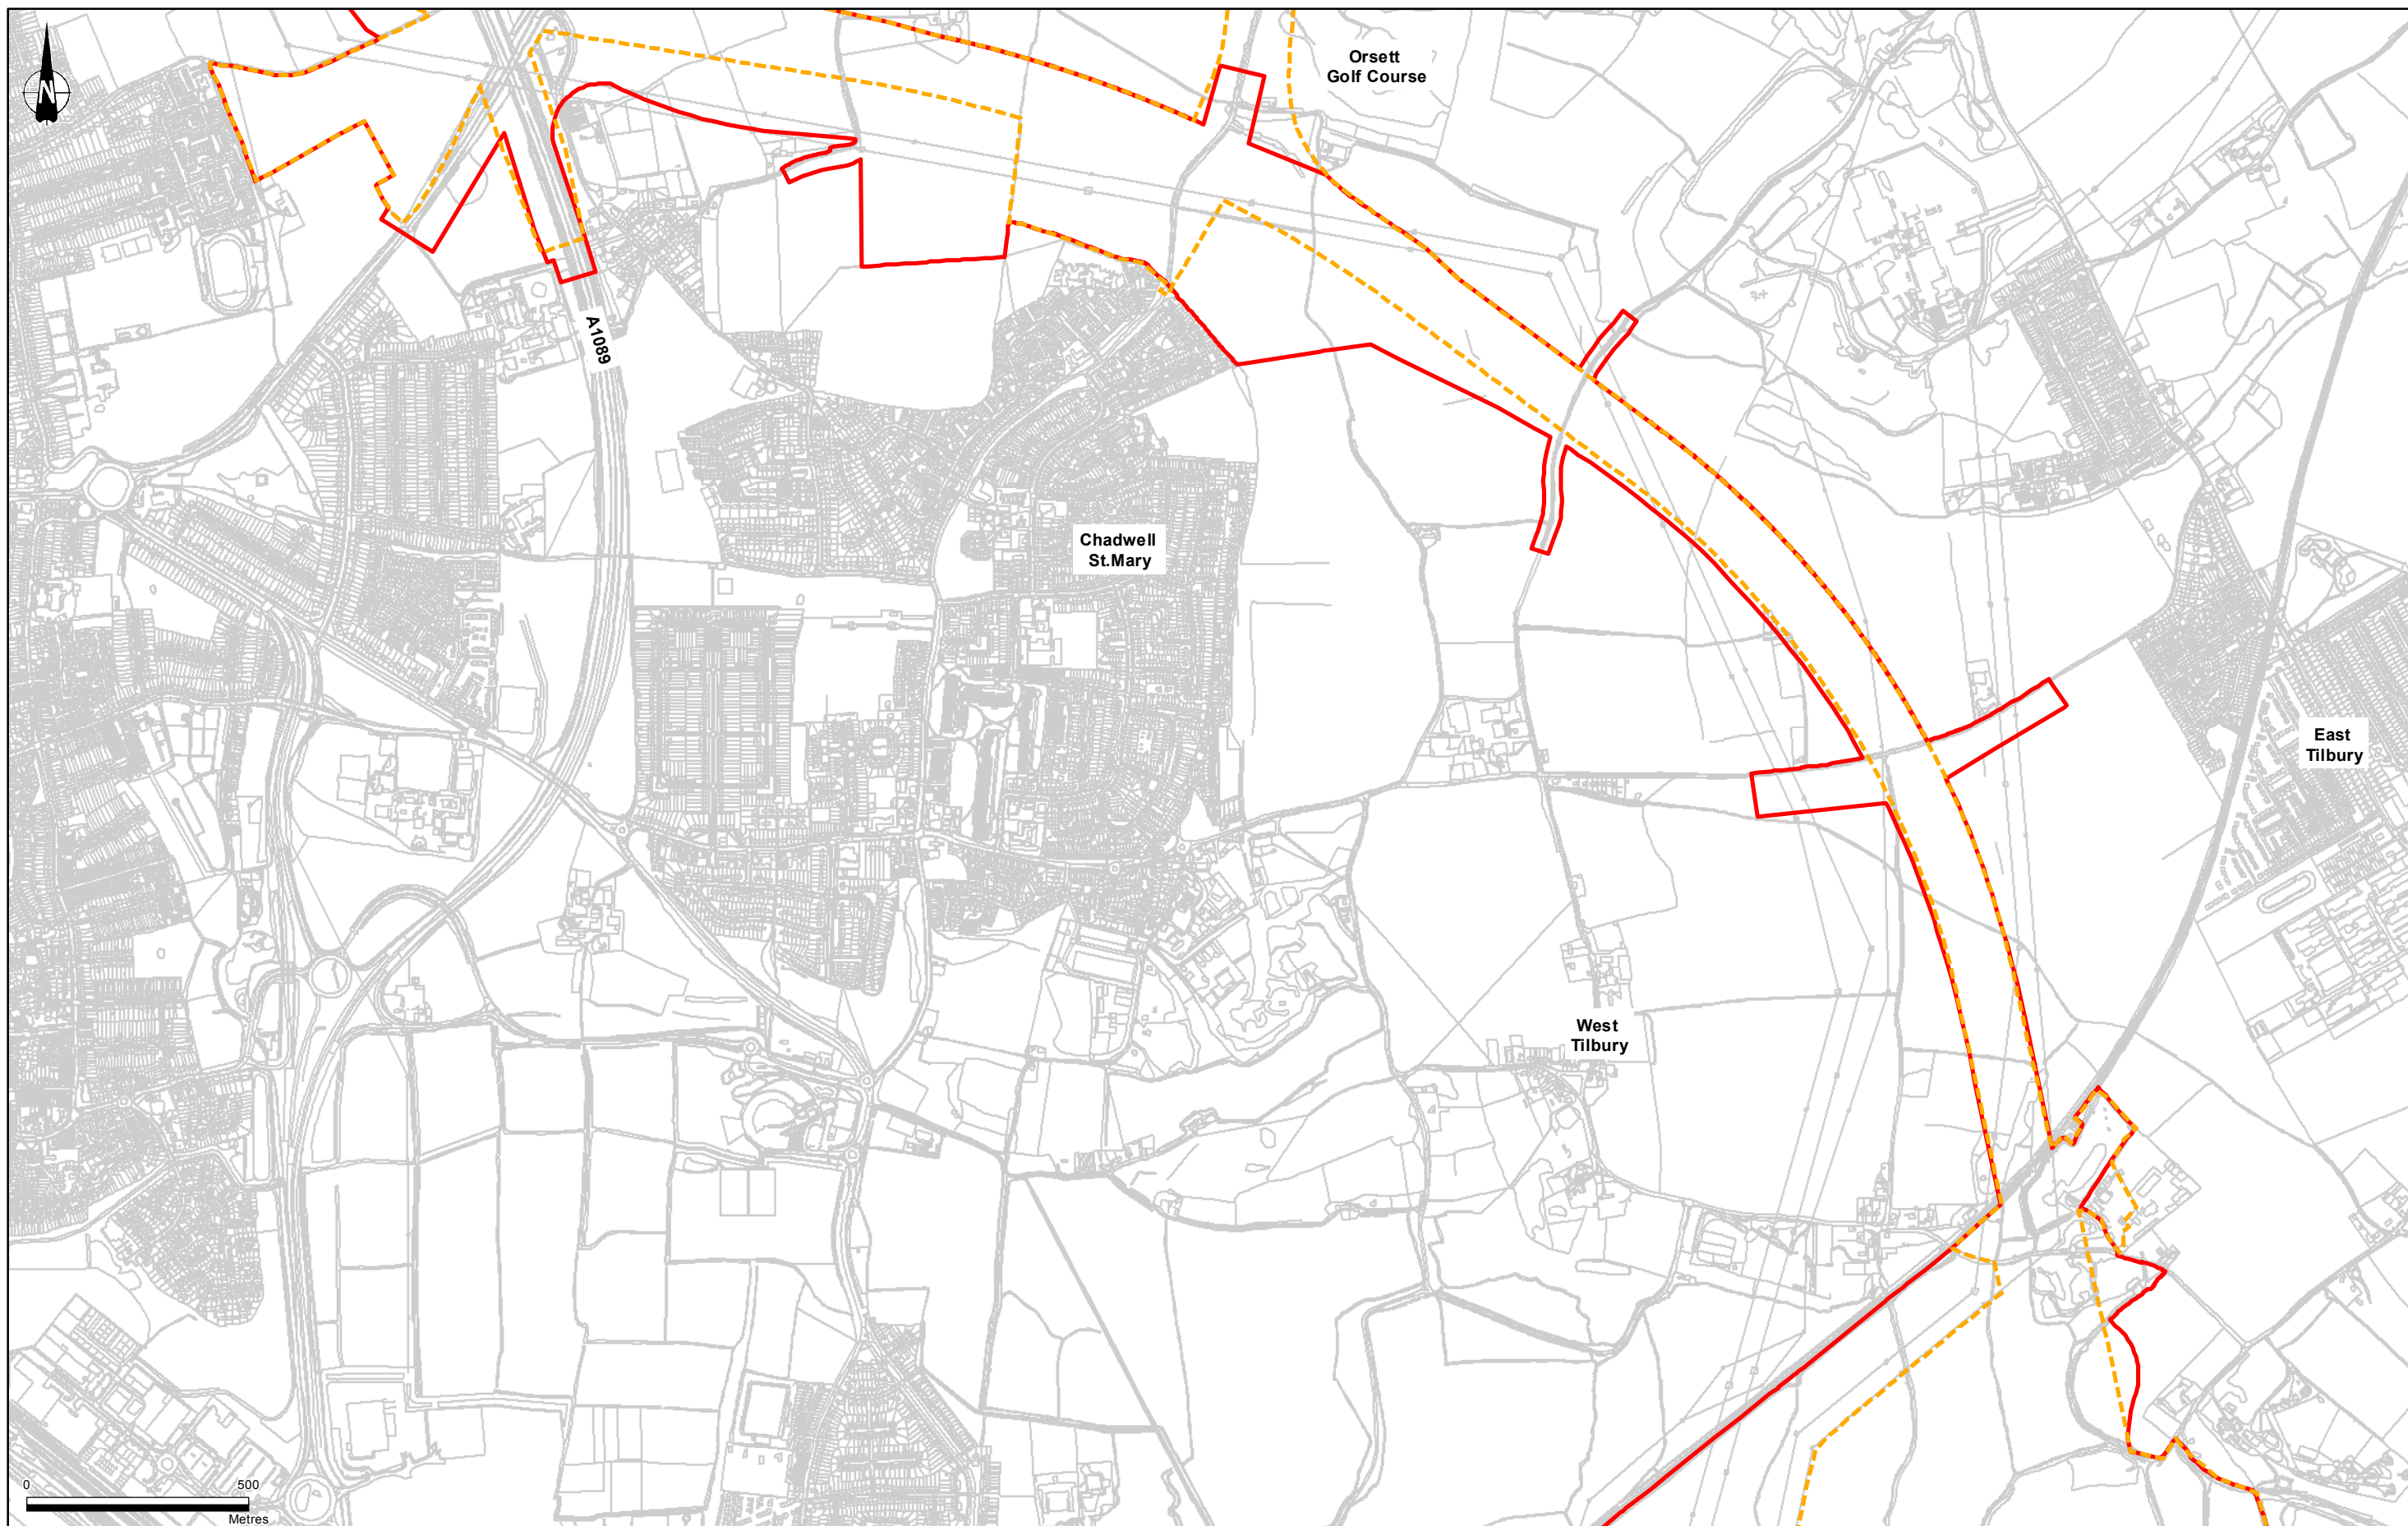
<div><div><div></div><div></div></div><div><div>Key:</div><div><div></div><div>Previously published boundary</div></div><div><div></div><div>Potential land required to construct and operate the Lower Thames Crossing</div></div></div></div>										<div>Client</div> <div><div><div></div><div>highways</div><div>england</div></div></div>		<div>Project</div> <div>LOWER THAMES CROSSING DEVELOPMENT PHASE</div>		<div>Status</div> <div>S2</div>		<div>Original Size</div> <div>A3</div>		<div>Revision</div> <div>001</div>	
										<div>Lower Thames Crossing</div>		<div>Drawing title</div> <div>Development Boundary Comparison Sheet 2 of 7</div>		<div>Scale</div> <div>1:14,000</div>		<div>Drawn</div> <div>JS/KM</div>		<div>Date</div> <div>10/10/2017</div>	
<div>Checked</div> <div>TG/TW</div>				<div>Date</div> <div>16/10/2017</div>		<div>Approved</div> <div>SC</div>		<div>Date</div> <div>16/10/2017</div>											
<div>Drawing number</div> <div>HE540039-CJV-GEN-GEN-MAP-DCO-00011</div>																			

001		S2		10/10/2017		Issued for information		JS/KM		TG/TW		SC	
Rev	Status	Rev. Date	Purpose of revision				Drawn	Chk'd	Appr'd				


Key:
 Previously published boundary
 Potential land required to construct and operate the Lower Thames Crossing

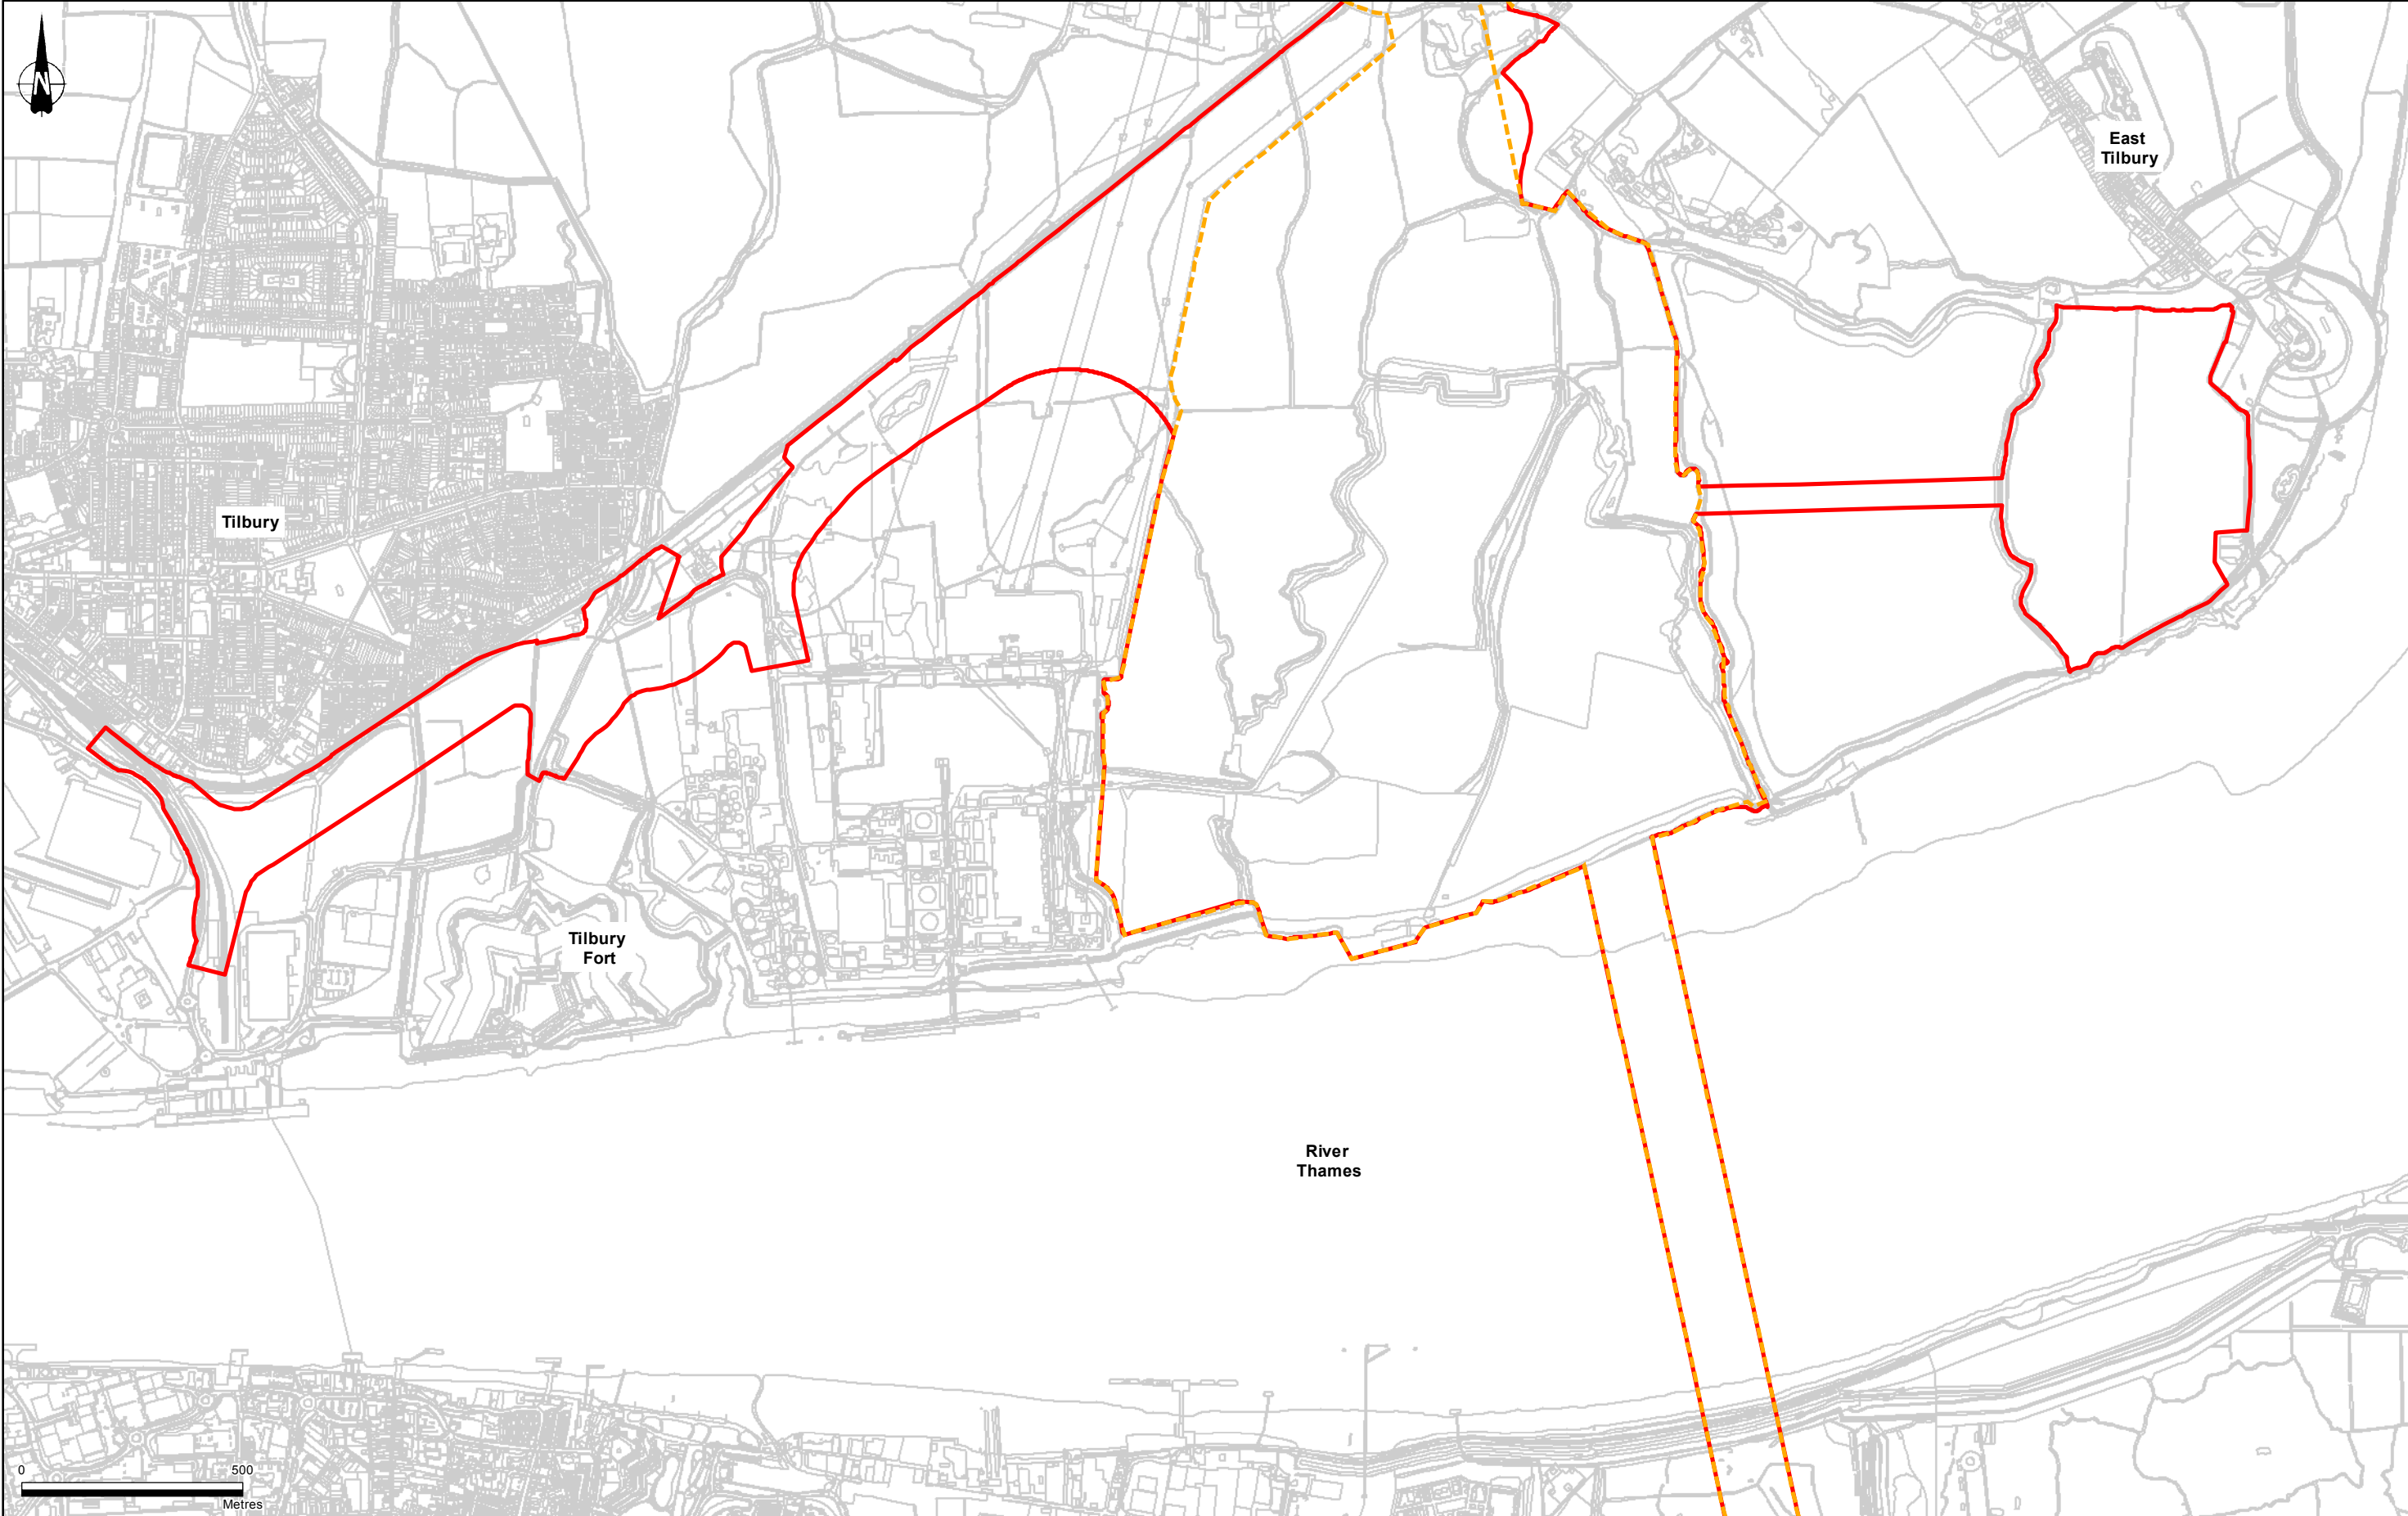


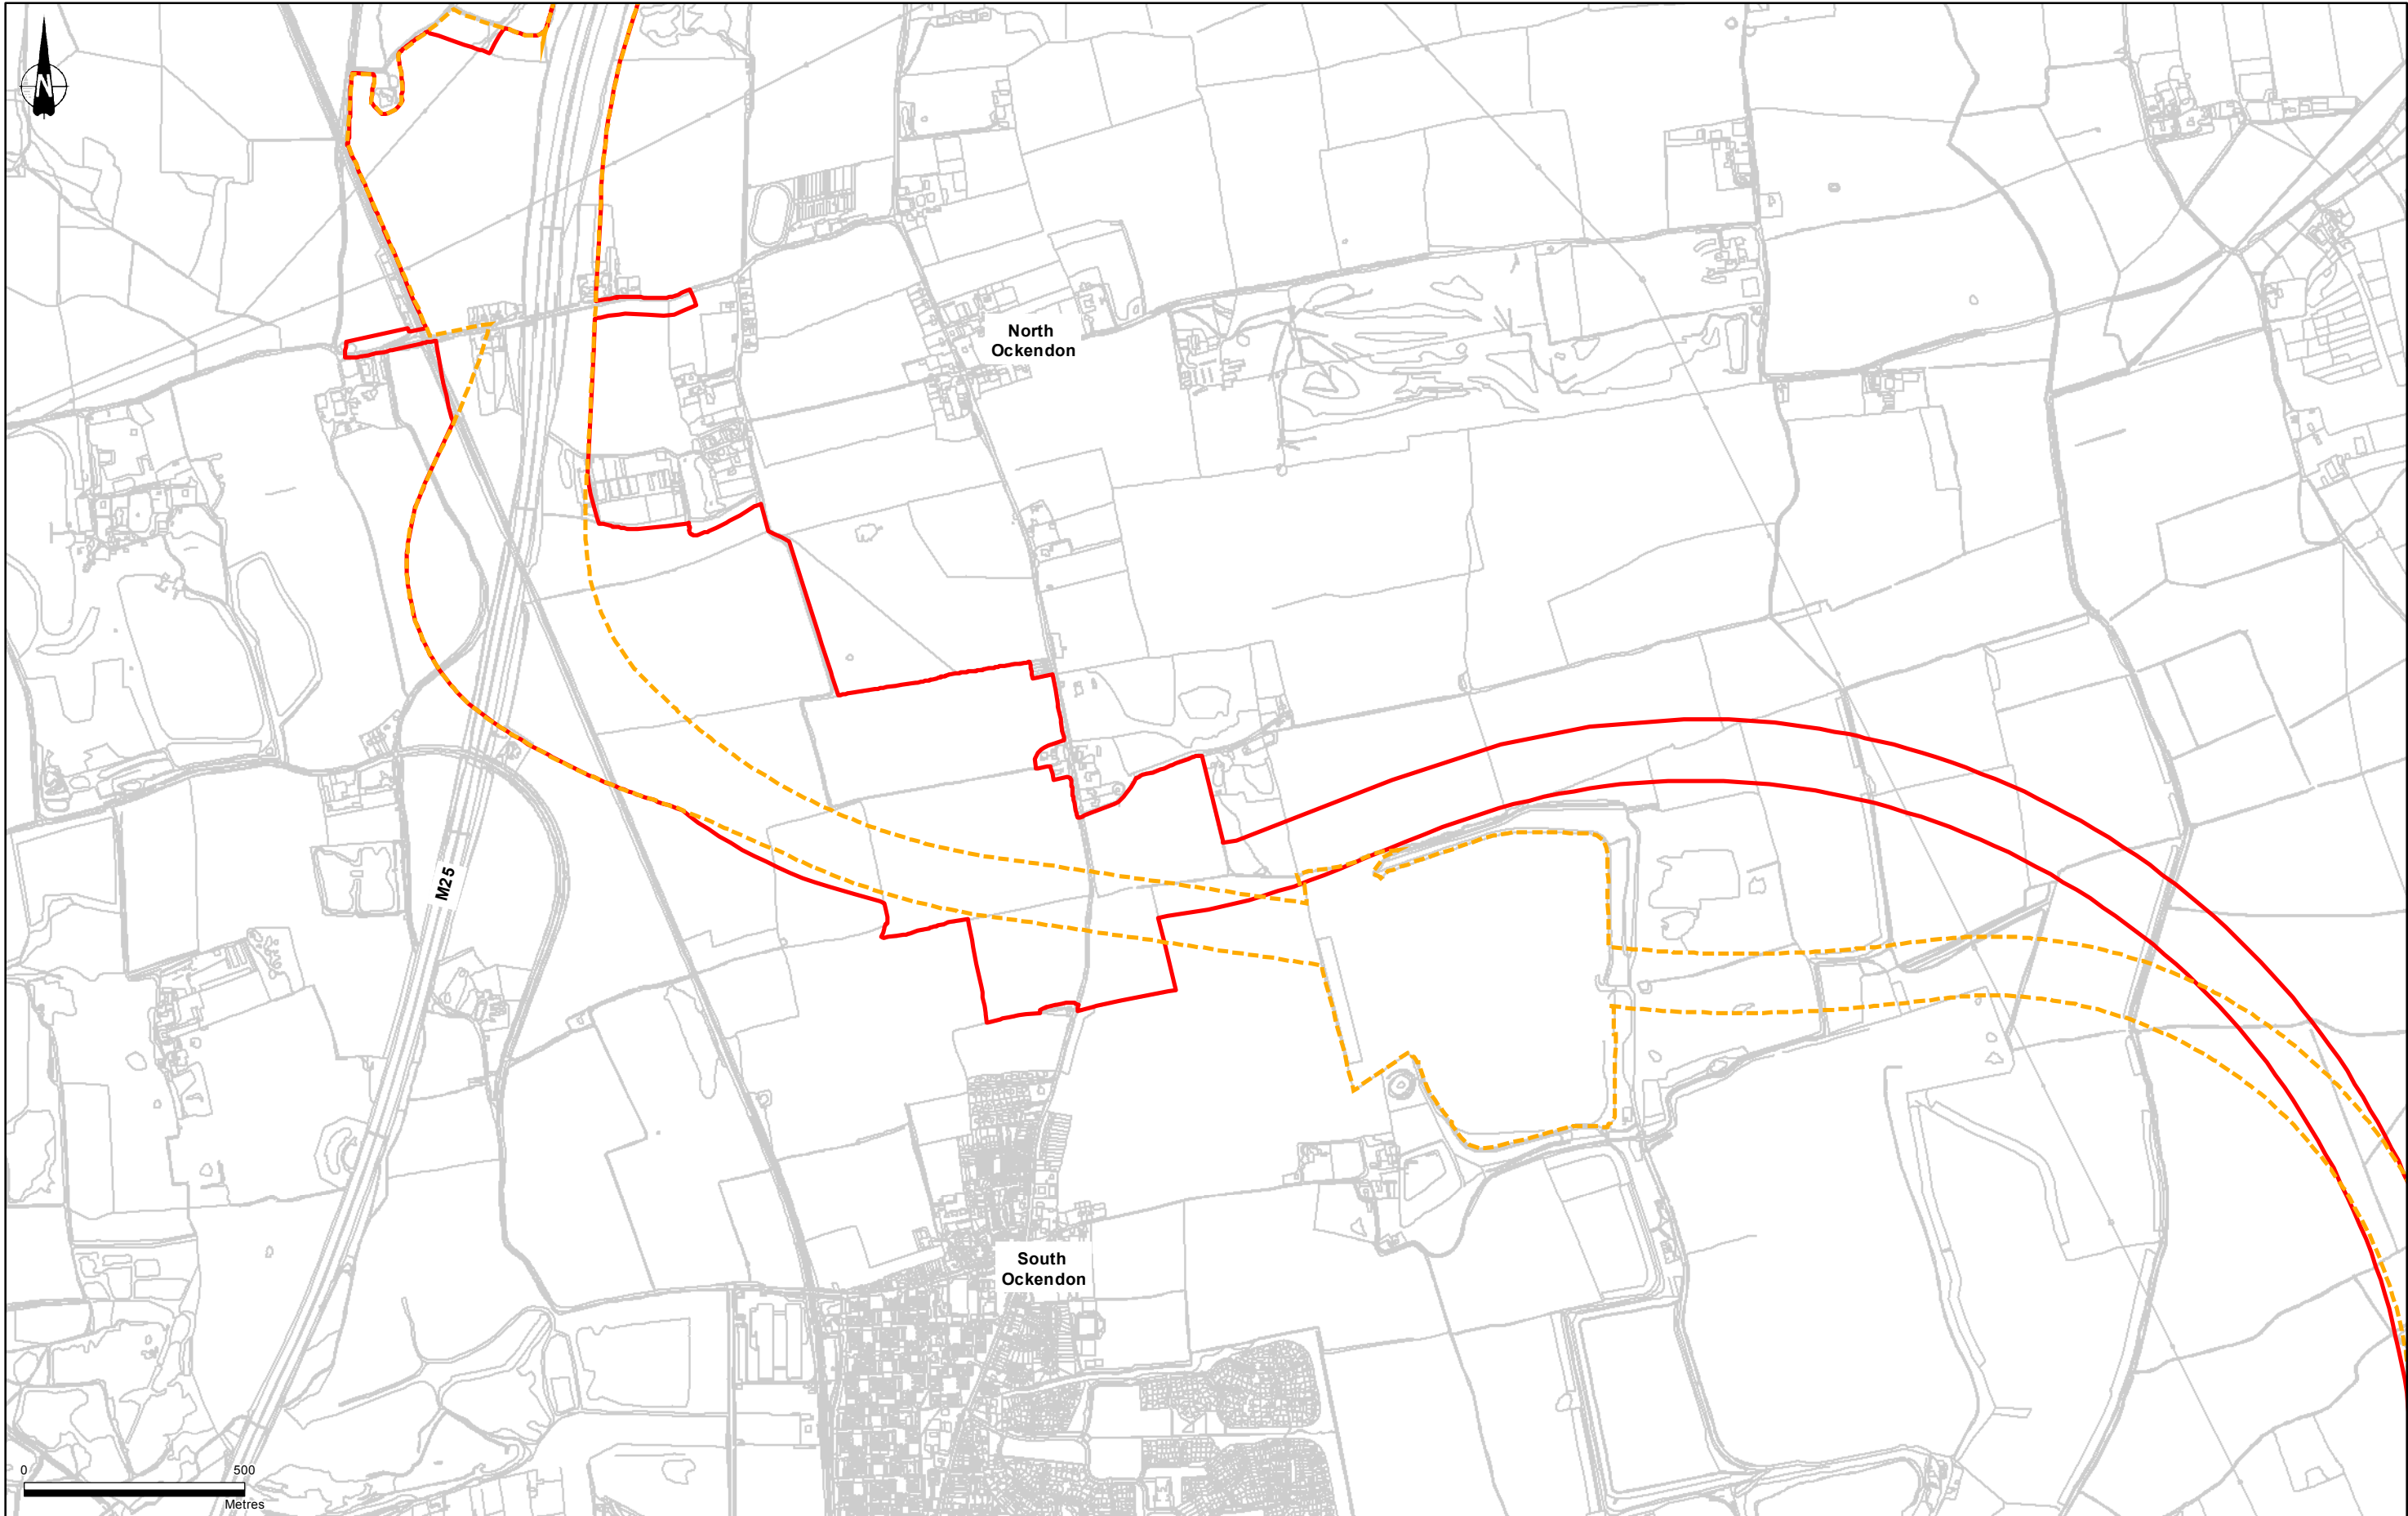
<div><div></div><div>Previously published boundary</div><div></div><div>Potential land required to construct and operate the Lower Thames Crossing</div></div> <div>001S210/10/2017Issued for informationJS/KMTG/TWSC</div> <table><tr><td>Rev</td><td>Status</td><td>Rev. Date</td><td>Purpose of revision</td><td>Drawn</td><td>Chk'd</td><td>Appr'd</td></tr><tr><td></td><td></td><td></td><td></td><td></td><td></td><td></td></tr></table>										Rev	Status	Rev. Date	Purpose of revision	Drawn	Chk'd	Appr'd								<div>Client<div>highways england</div><div>Lower Thames Crossing</div></div>		<div>Project<div>LOWER THAMES CROSSING DEVELOPMENT PHASE</div><div>Drawing title<div>Development Boundary Comparison Sheet 3 of 7</div></div></div>		<div>Status<div>S2</div><div>Original Size<div>A3</div>Revision<div>001</div>Scale<div>1:14,000</div></div><div><div>Drawn<div>JS/KM</div>Date<div>10/10/2017</div></div><div>Checked<div>TG/TW</div>Date<div>16/10/2017</div></div><div>Approved<div>SC</div>Date<div>16/10/2017</div></div><div>Drawing number<div>HE540039-CJV-GEN-GEN-MAP-DCO-00012</div></div></div></div>	
										Rev	Status	Rev. Date	Purpose of revision	Drawn	Chk'd	Appr'd													




<div> <div> <div>001</div> <div>S2</div> <div>10/10/2017</div> <div>Issued for information</div> <div>JS/KM</div> <div>TG/TW</div> <div>SC</div> </div> <div> <div>Rev</div> <div>Status</div> <div>Rev Date</div> <div>Purpose of revision</div> <div>Drawn</div> <div>Chk'd</div> <div>Appr'd</div> </div> </div>	<div> <div>Key:</div> <div> <div></div> <div>Previously published boundary</div> </div> <div> <div></div> <div>Potential land required to construct and operate the Lower Thames Crossing</div> </div> </div>	<div> <div>Client</div> <div> </div> <div>Lower Thames Crossing</div> </div>	<div>Project</div> <div>LOWER THAMES CROSSING DEVELOPMENT PHASE</div>	<div>Status</div> <div>S2</div> <div> <div>Original Size</div> <div>A3</div> </div> <div> <div>Revision</div> <div>001</div> </div> <div>Scale</div> <div>1:14,000</div>
			<div>Drawing title</div> <div>Development Boundary Comparison Sheet 4 of 7</div>	<div> <div>Drawn</div> <div>JS/KM</div> <div>Date</div> <div>10/10/2017</div> </div> <div> <div>Checked</div> <div>TG/TW</div> <div>Date</div> <div>16/10/2017</div> </div> <div> <div>Approved</div> <div>SC</div> <div>Date</div> <div>16/10/2017</div> </div> <div> <div>Drawing number</div> <div>HE540039-CJV-GEN-GEN-MAP-DCO-00013</div> </div>

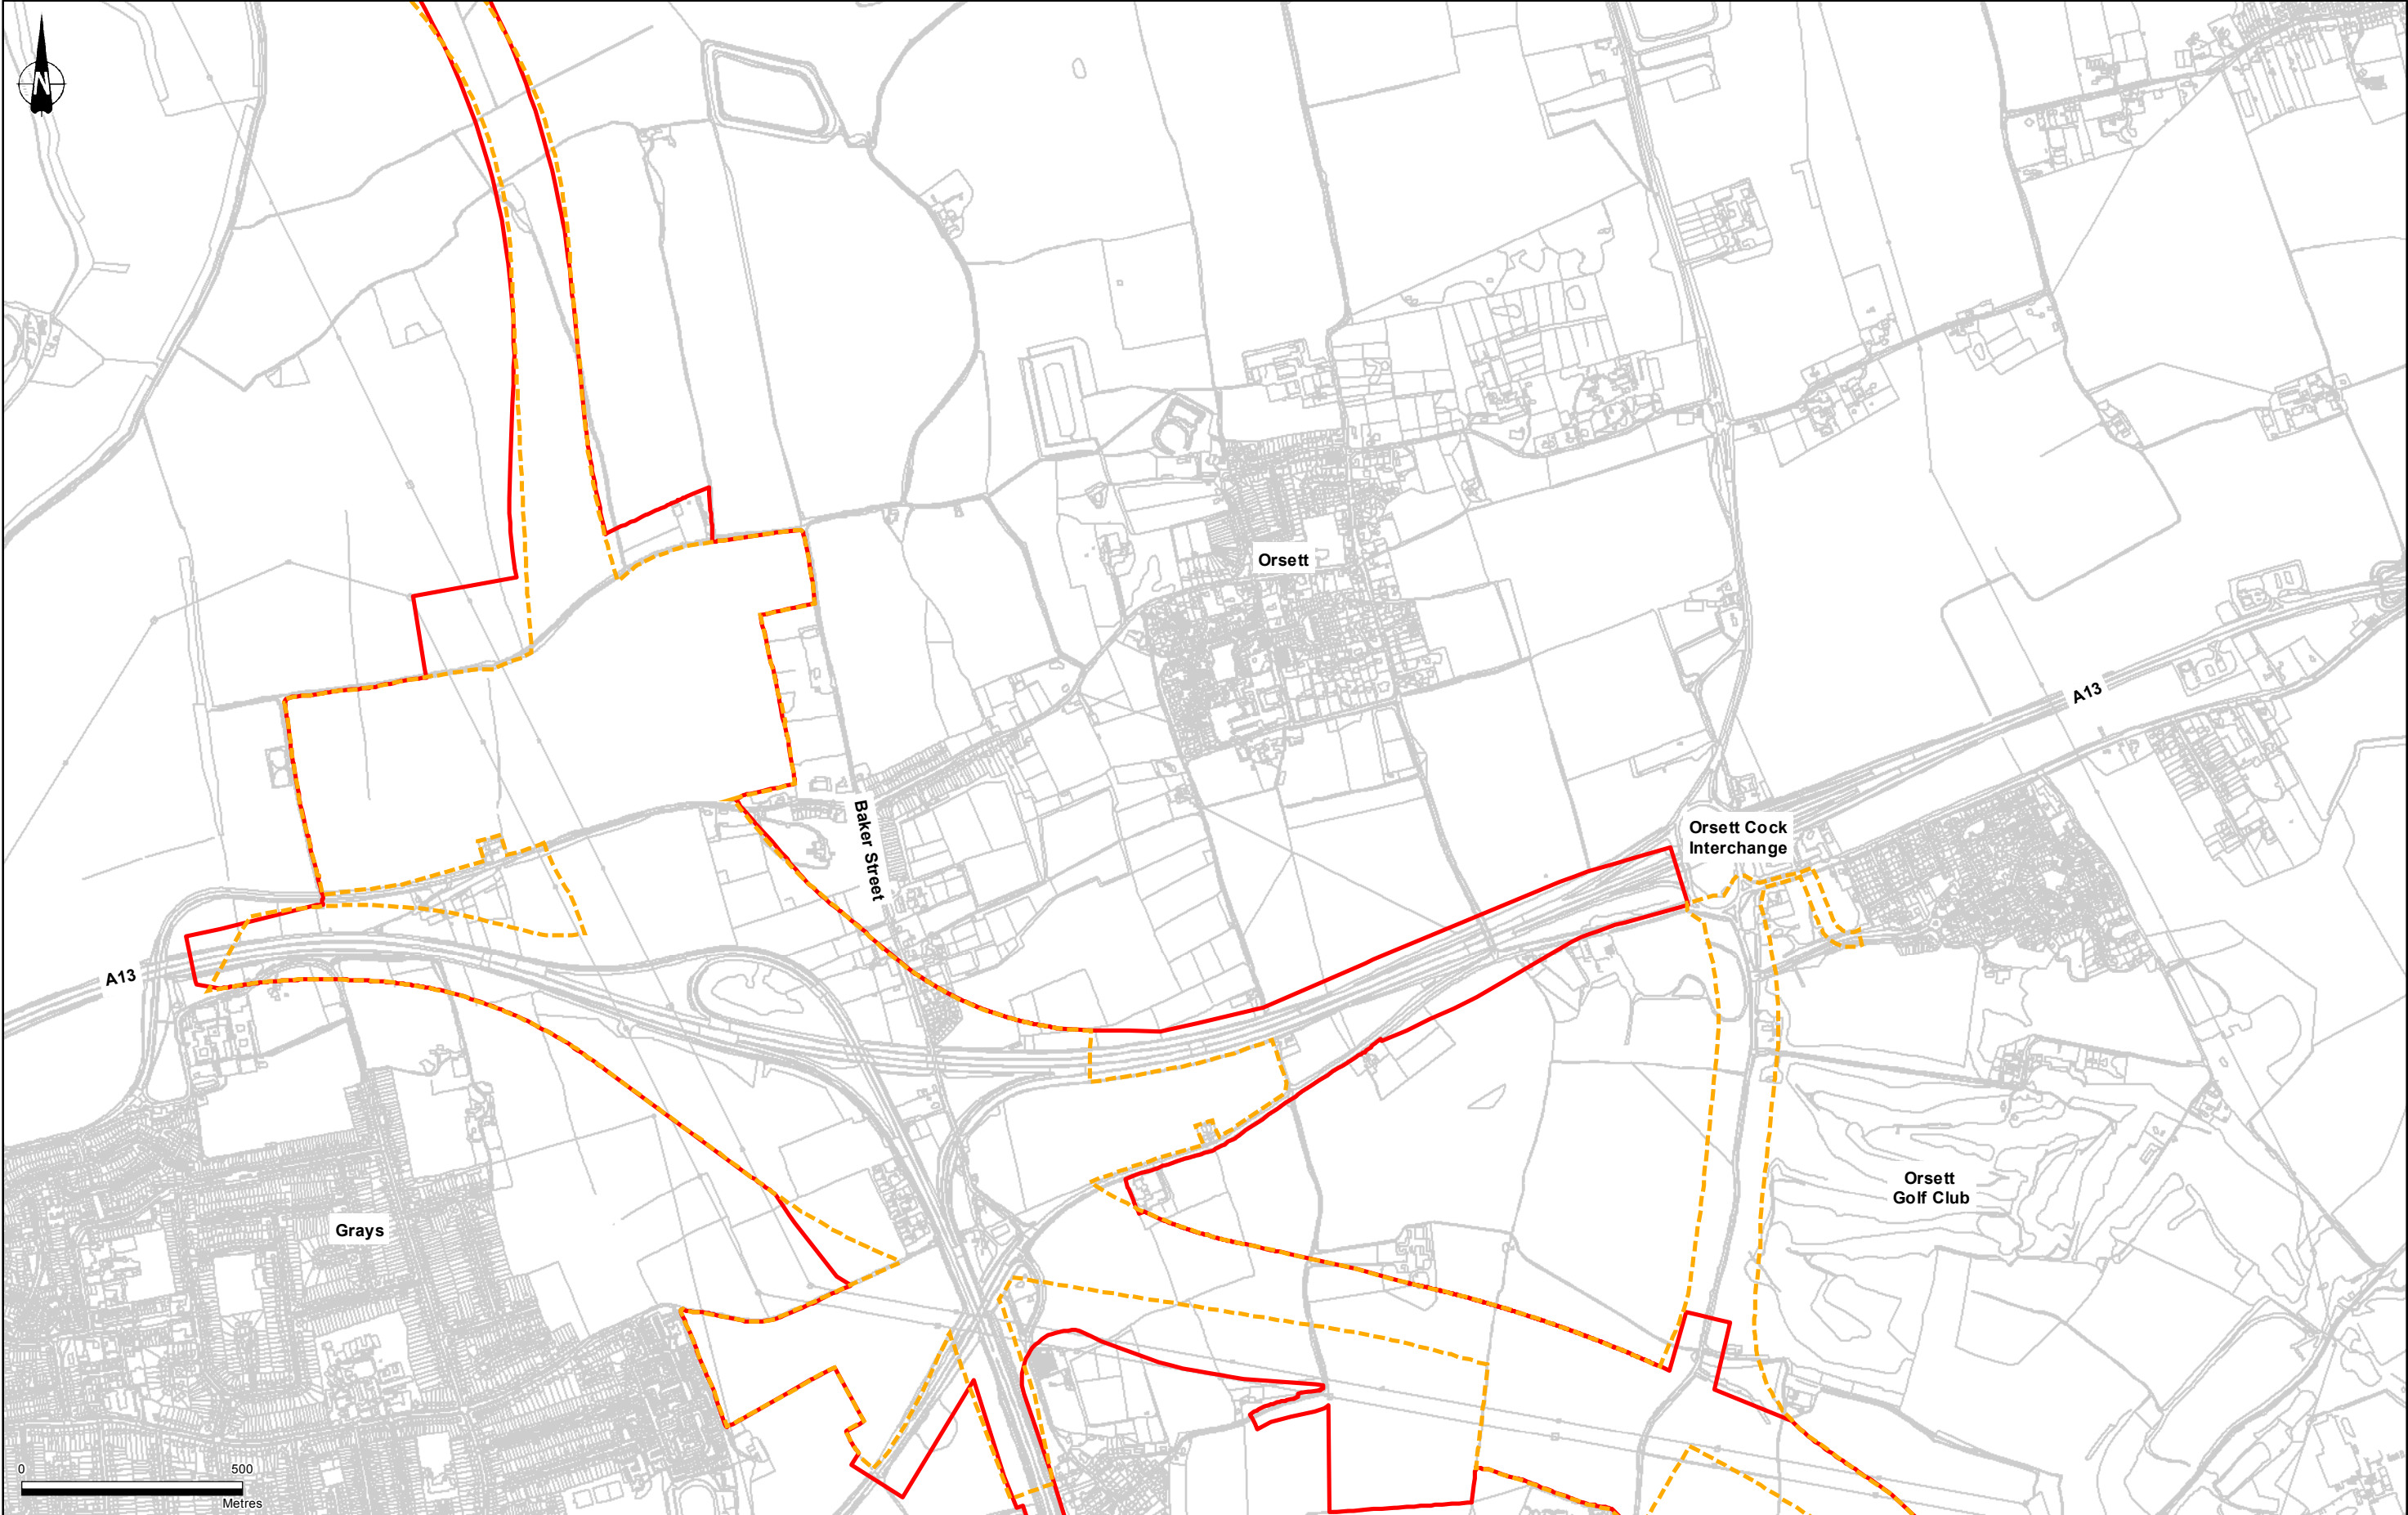

001 S2 10/10/2017 Issued for information JS/KM TG/TW SC				 Lower Thames Crossing		Project LOWER THAMES CROSSING DEVELOPMENT PHASE		Status S2		Original Size A3	Revision 001
Rev	Status	Rev. Date	Purpose of revision	Drawn	Chk'd	Appr'd	Drawing title	Scale 1:14,000		Date - 10/10/2017	
						Development Boundary Comparison Sheet 5 of 7		Drawn JS/KM	Checked TG/TW	Date - 16/10/2017	
								Approved SC		Date - 16/10/2017	
								Drawing number HE540039-CJV-GEN-GEN-MAP-DCO-00014			



<div>001</div> <div>S2</div> <div>10/10/2017</div> <div>Issued for information</div> <div>JS/KM</div> <div>TG/TW</div> <div>SC</div>										<div>Key:</div> <div><div></div>Previously published boundary</div> <div><div></div>Potential land required to construct and operate the Lower Thames Crossing</div>										<div>Client</div> <div><div></div></div> <div>Lower Thames Crossing</div>										<div>Project</div> <div>LOWER THAMES CROSSING DEVELOPMENT PHASE</div> <div>Drawing title</div> <div>Development Boundary Comparison Sheet 6 of 7</div>										<div>Status</div> <div>S2</div> <div>Original Size</div> <div>A3</div> <div>Revision</div> <div>001</div> <div>Scale</div> <div>1:14,000</div> <div>Drawn</div> <div>JS/KM</div> <div>Date</div> <div>10/10/2017</div> <div>Checked</div> <div>TG/TW</div> <div>Date</div> <div>16/10/2017</div> <div>Approved</div> <div>SC</div> <div>Date</div> <div>16/10/2017</div> <div>Drawing number</div> <div>HE540039-CJV-GEN-GEN-MAP-DCO-00015</div>																																																																																																																																																																																																																																																																																																																																																																																																																																																																																																																																																																																																																																																																																																																																																																																																																																																																																																																																																																																																																																																																																																																																																																																																																																																																																																																																																																																																																																																																																																																																																																																																																																																																																																																																																																																																																																									
Rev	Status	Rev. Date	Purpose of revision	Drawn	Chk'd	Appr'd																																																																																																																																																																																																																																																																																																																																																																																																																																																																																																																																																																																																																																																																																																																																																																																																																																																																																																																																																																																																																																																																																																																																																																																																																																																																																																																																																																																																																																																																																																																																																																																																																																																																																																																																																																																																																																																																											

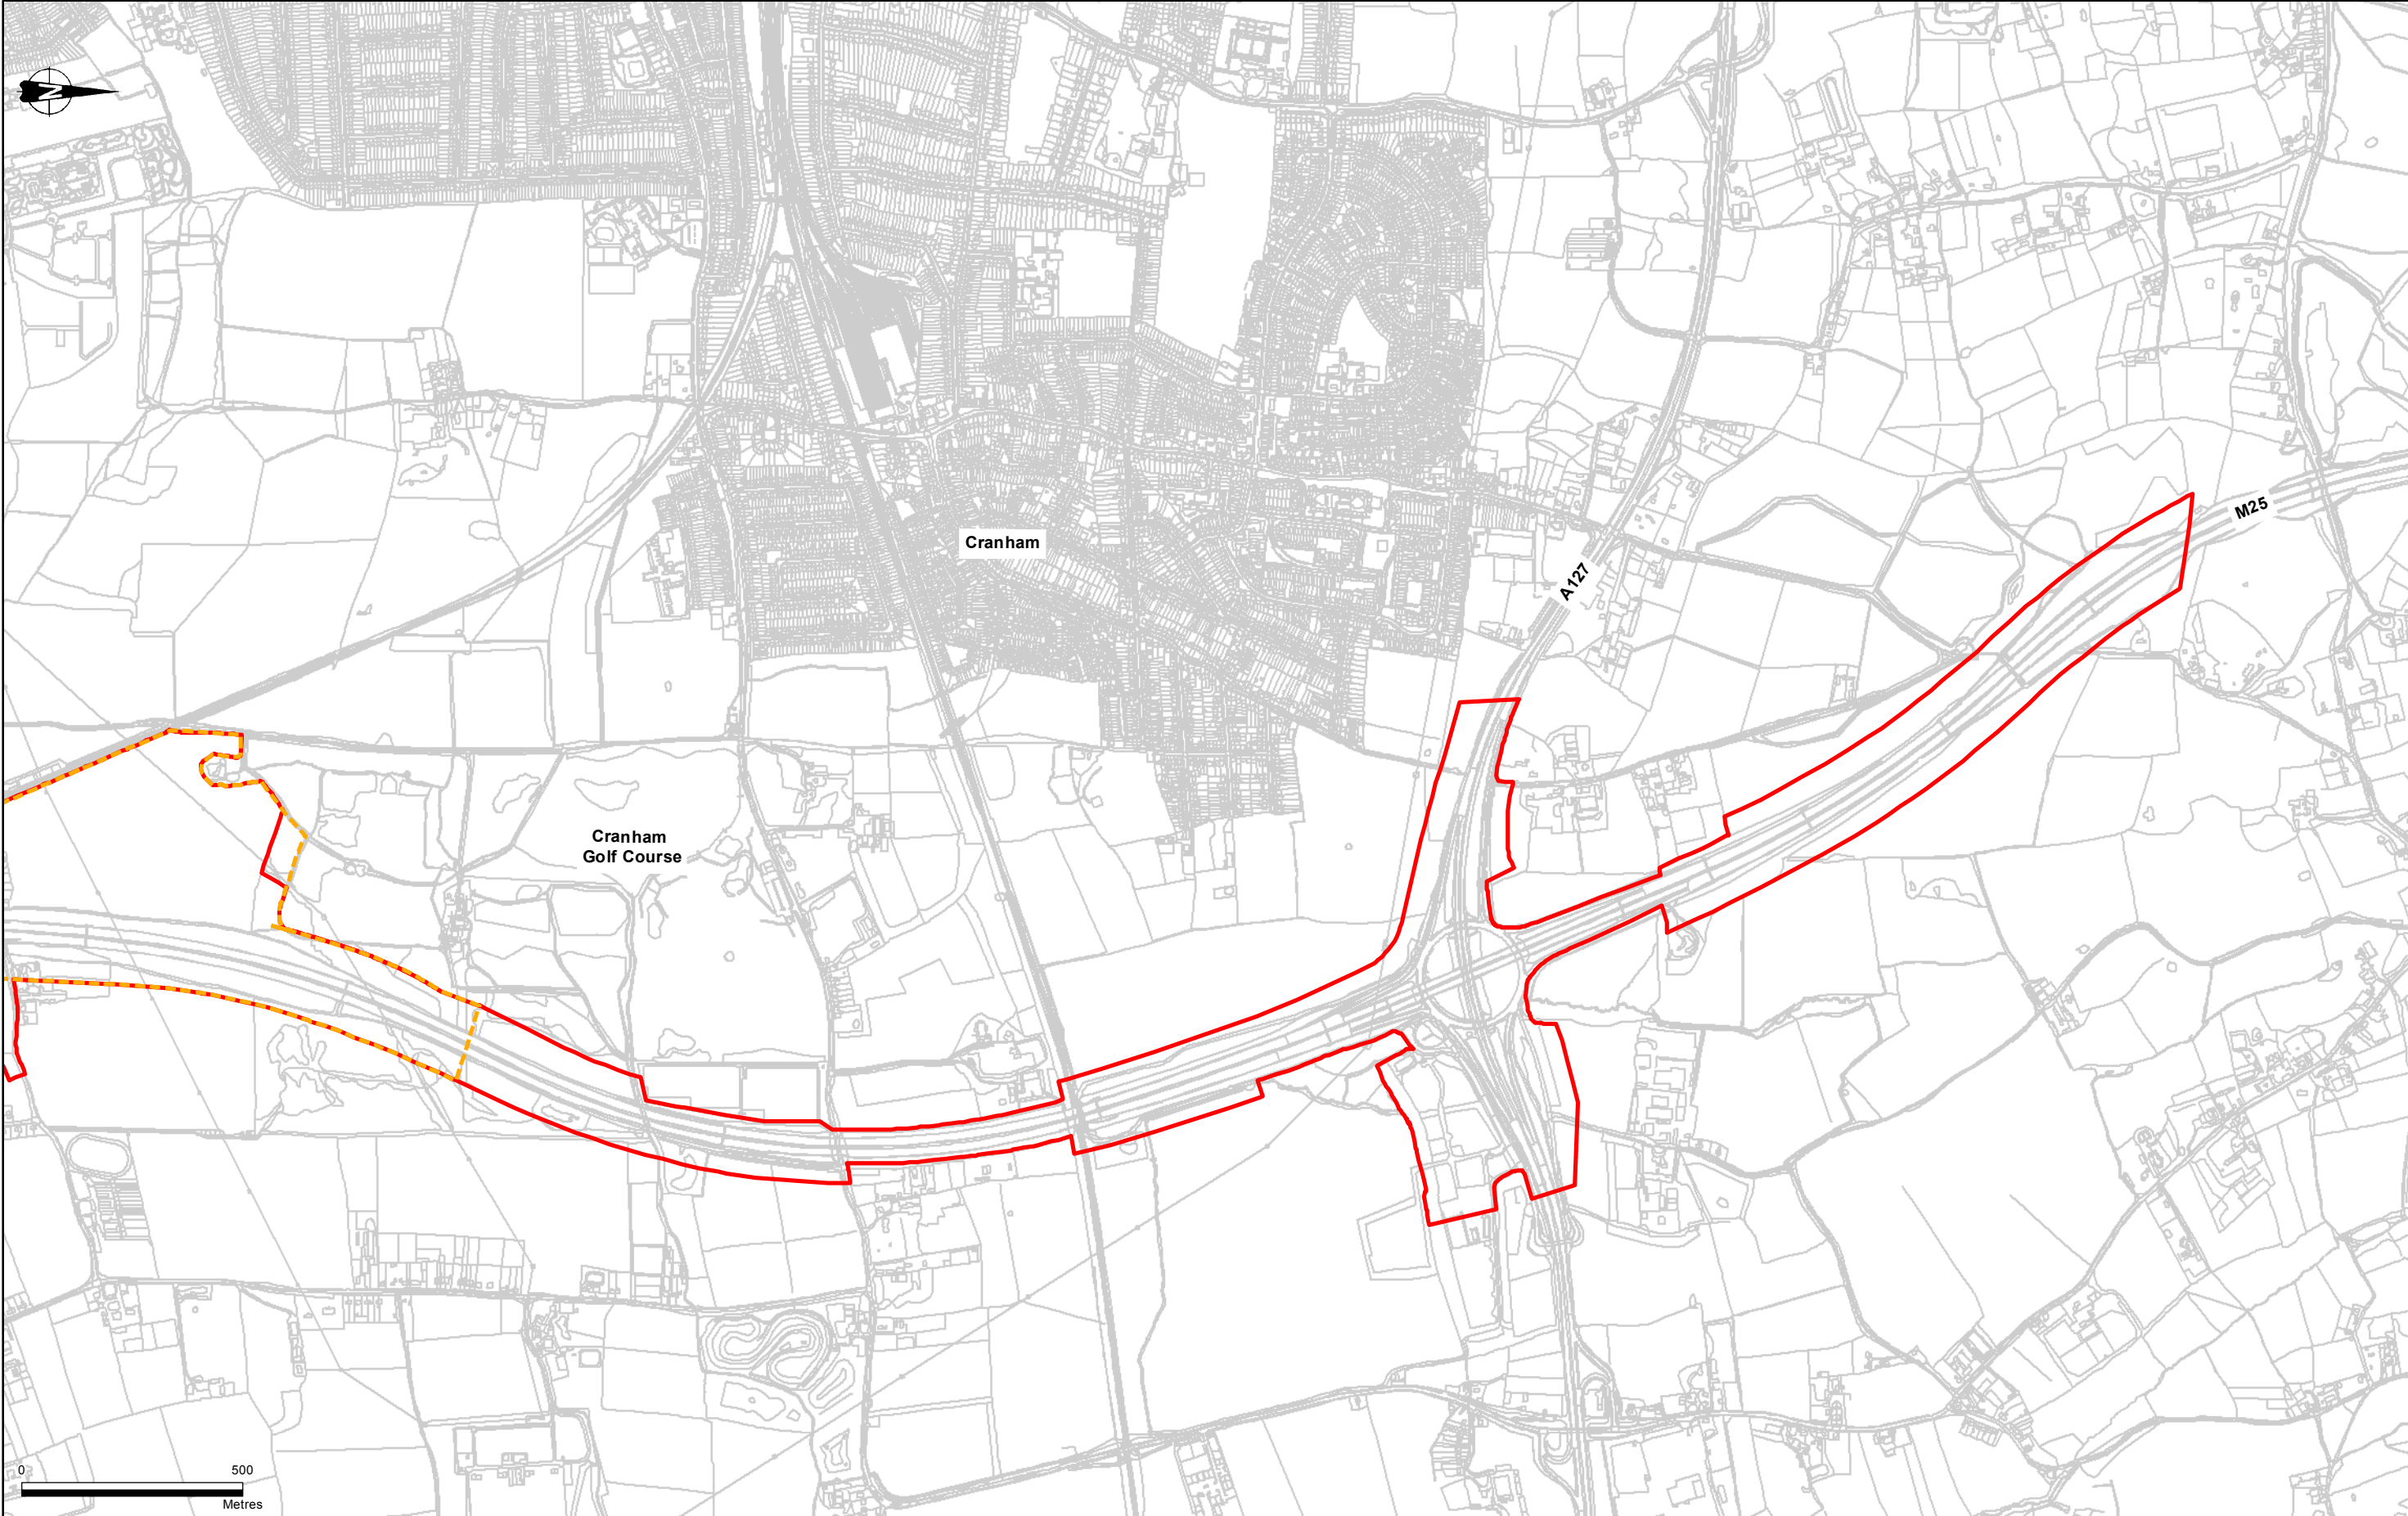

001 S2 10/10/2017 Issued for information JS/KM TG/TW SC				Key: <div><div></div> Previously published boundary <div></div> Potential land required to construct and operate the Lower Thames Crossing</div>		Client <div></div> Lower Thames Crossing		Project LOWER THAMES CROSSING DEVELOPMENT PHASE Drawing title Development Boundary Comparison Sheet 7 of 7		Status S2 Drawn JS/KM Checked TG/TW Approved SC Drawing number HE540039-CJV-GEN-GEN-MAP-DCO-00016		Original Size A3 Scale 1:14,000 Date - 10/10/2017 Date - 16/10/2017 Date - 16/10/2017	
Rev	Status	Rev. Date	Purpose of revision	Drawn	Chk'd	Appr'd							